

**CDC D3E351**

# **Structural Journeyman**

**Supplementary Material for Volume 2**

**Foldouts 1– 8**



**Air Force Career Development Academy**

**The Air University**

**Air Education and Training Command**

## **Table of Foldouts**

Foldout 1. Site plan.

Foldout 2. Floor plan.

Foldout 3. Interior elevation.


Foldout 4. Exterior elevation.

Foldout 5. Foundation plan.


Foldout 6. Building section.

Foldout 7. Schedules.


Foldout 8. General notes.

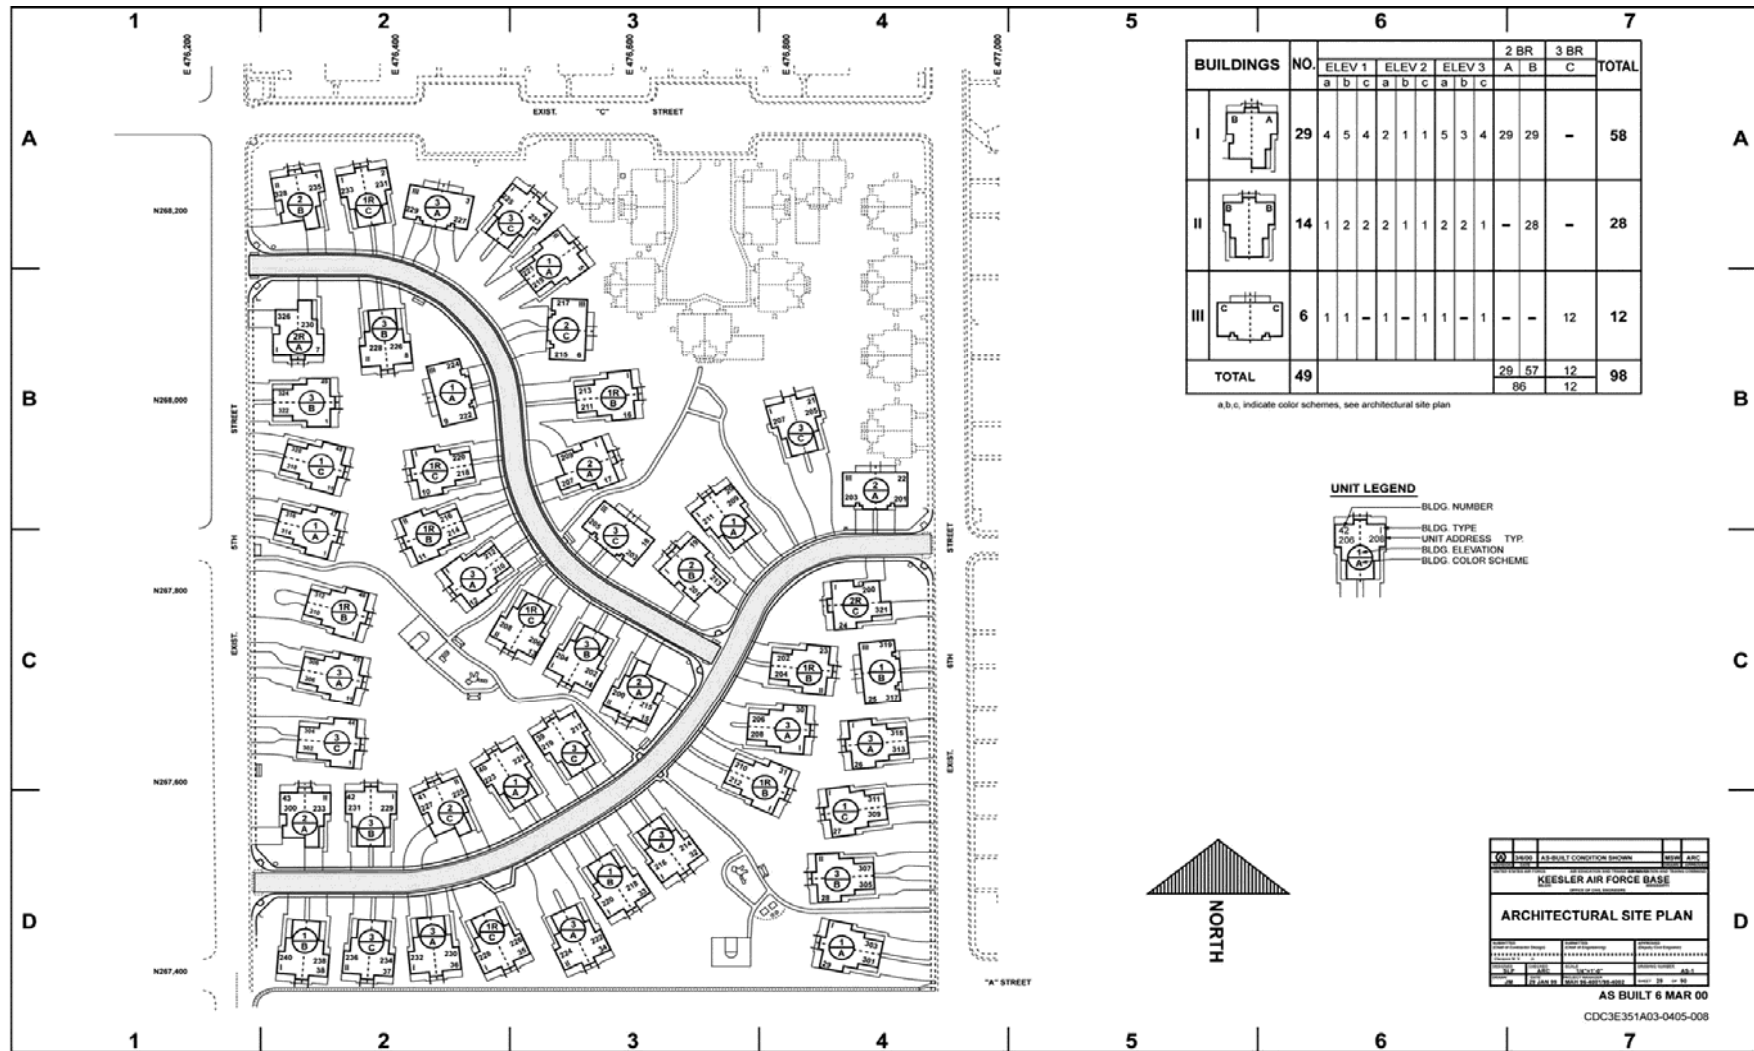


Foldout 1. Site plan.

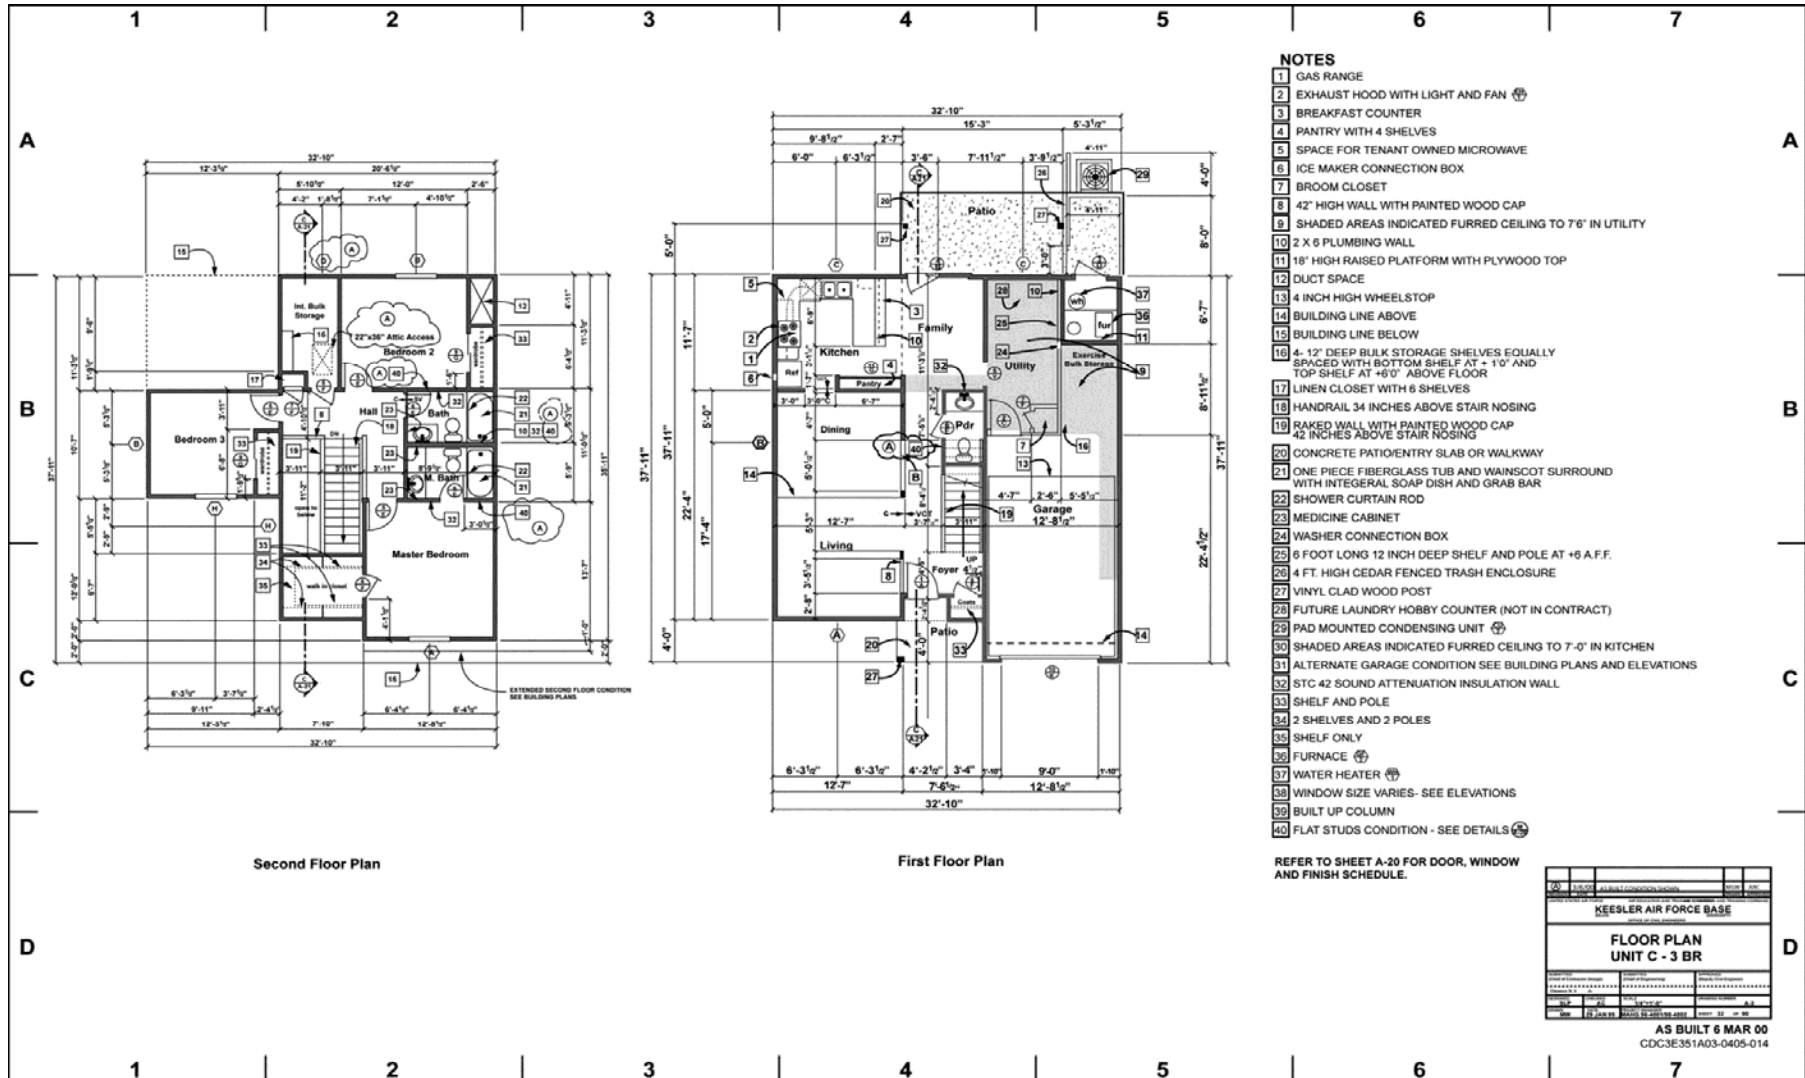


Foldout 2. Floor plan.

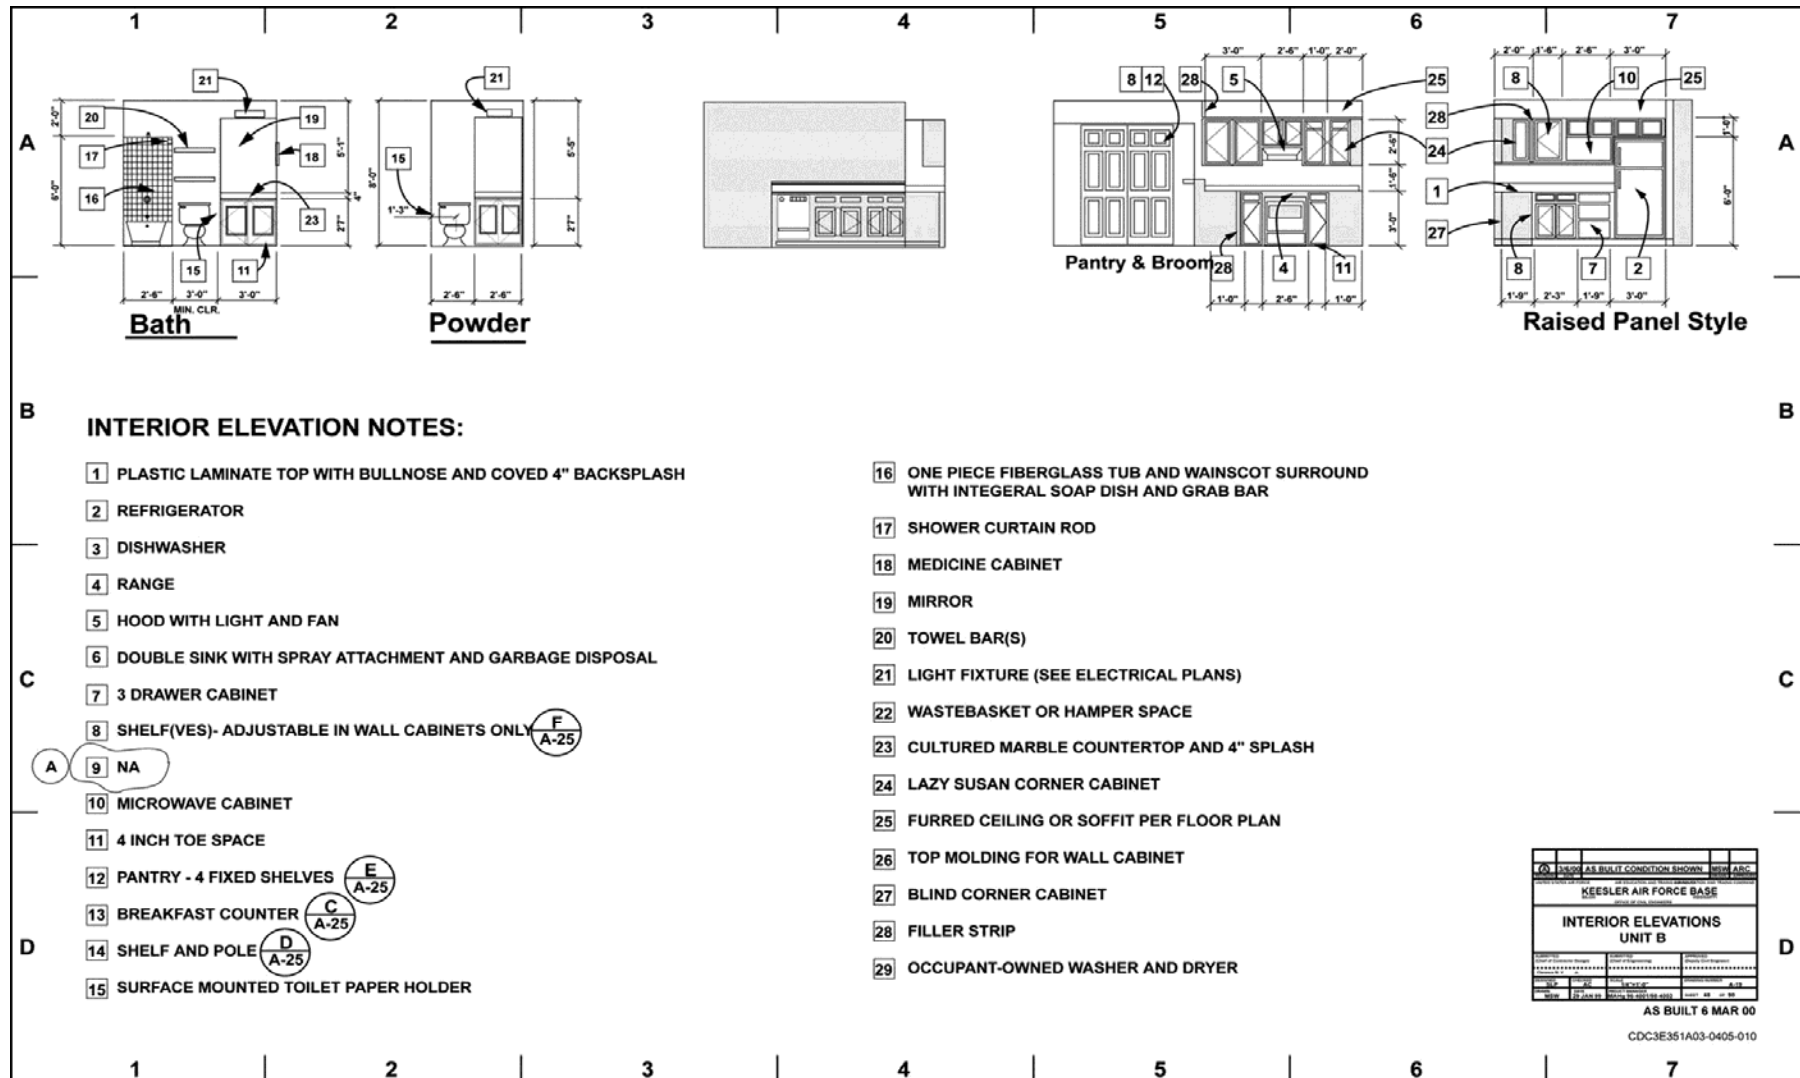


Foldout 3. Interior elevation.

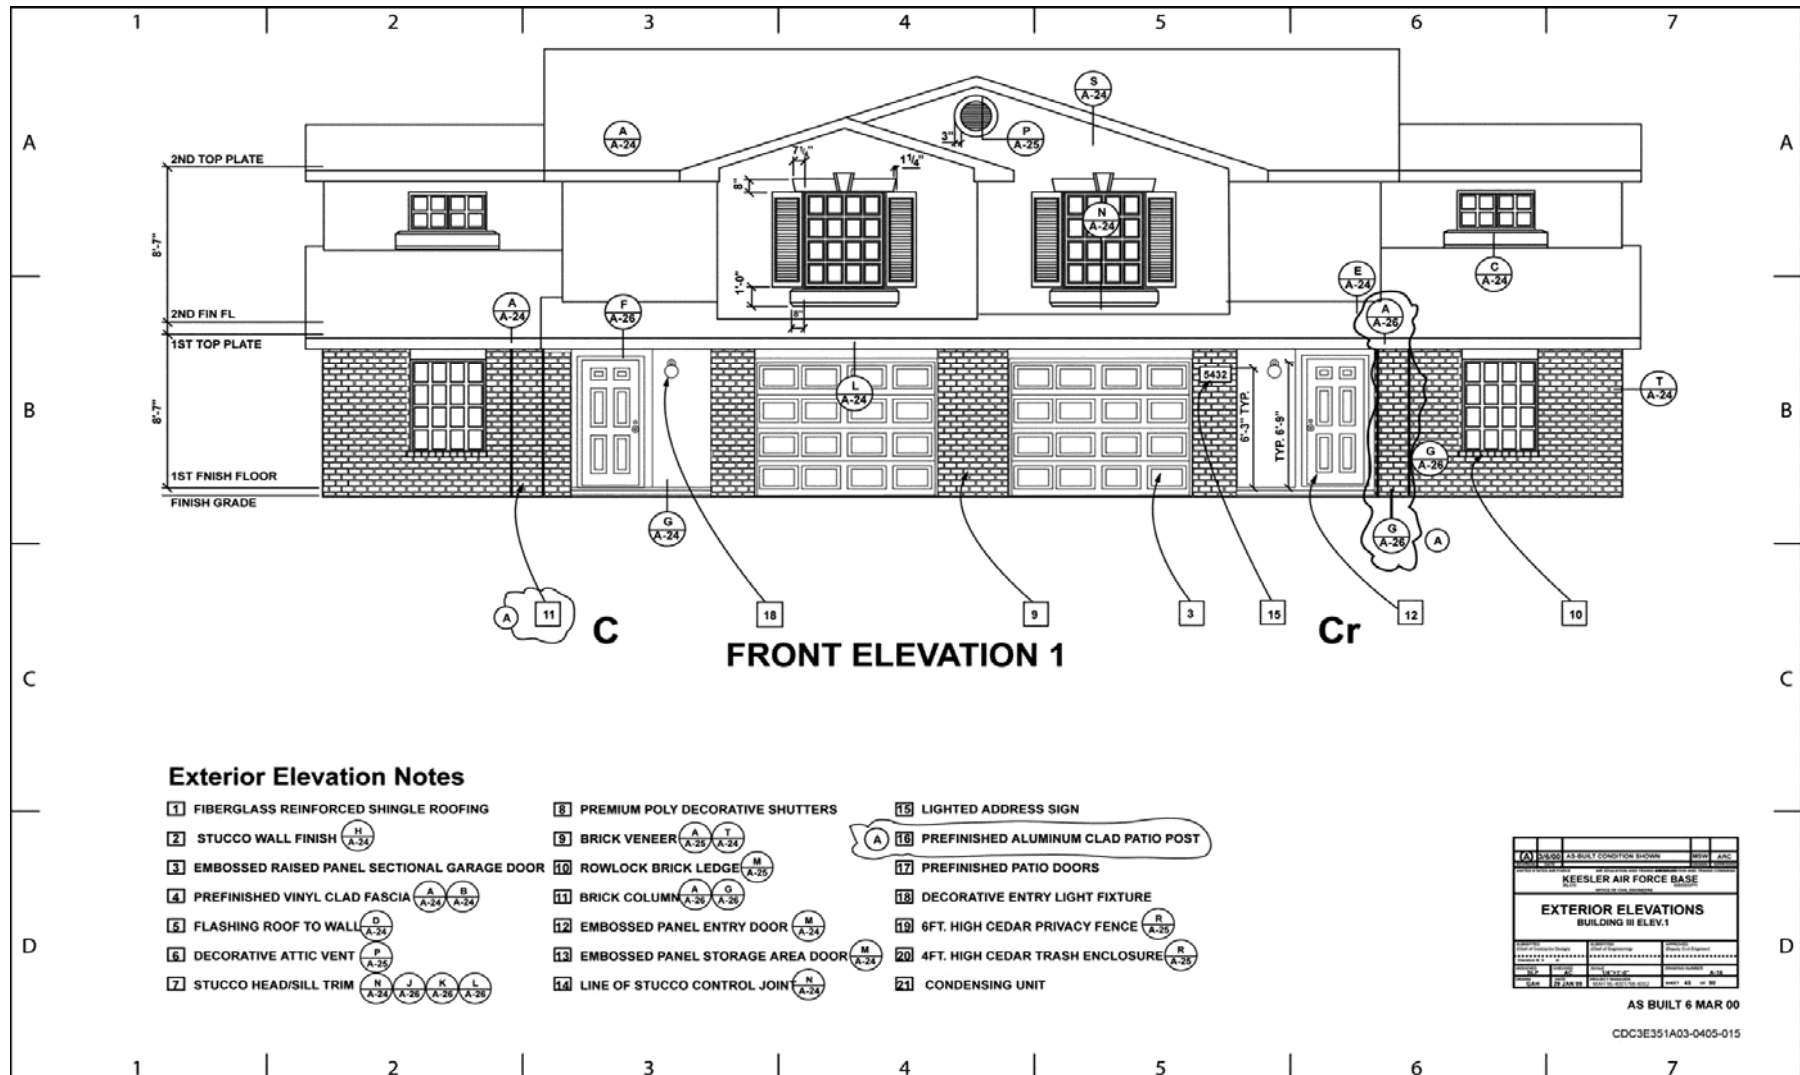

Foldout 4. Exterior elevation.

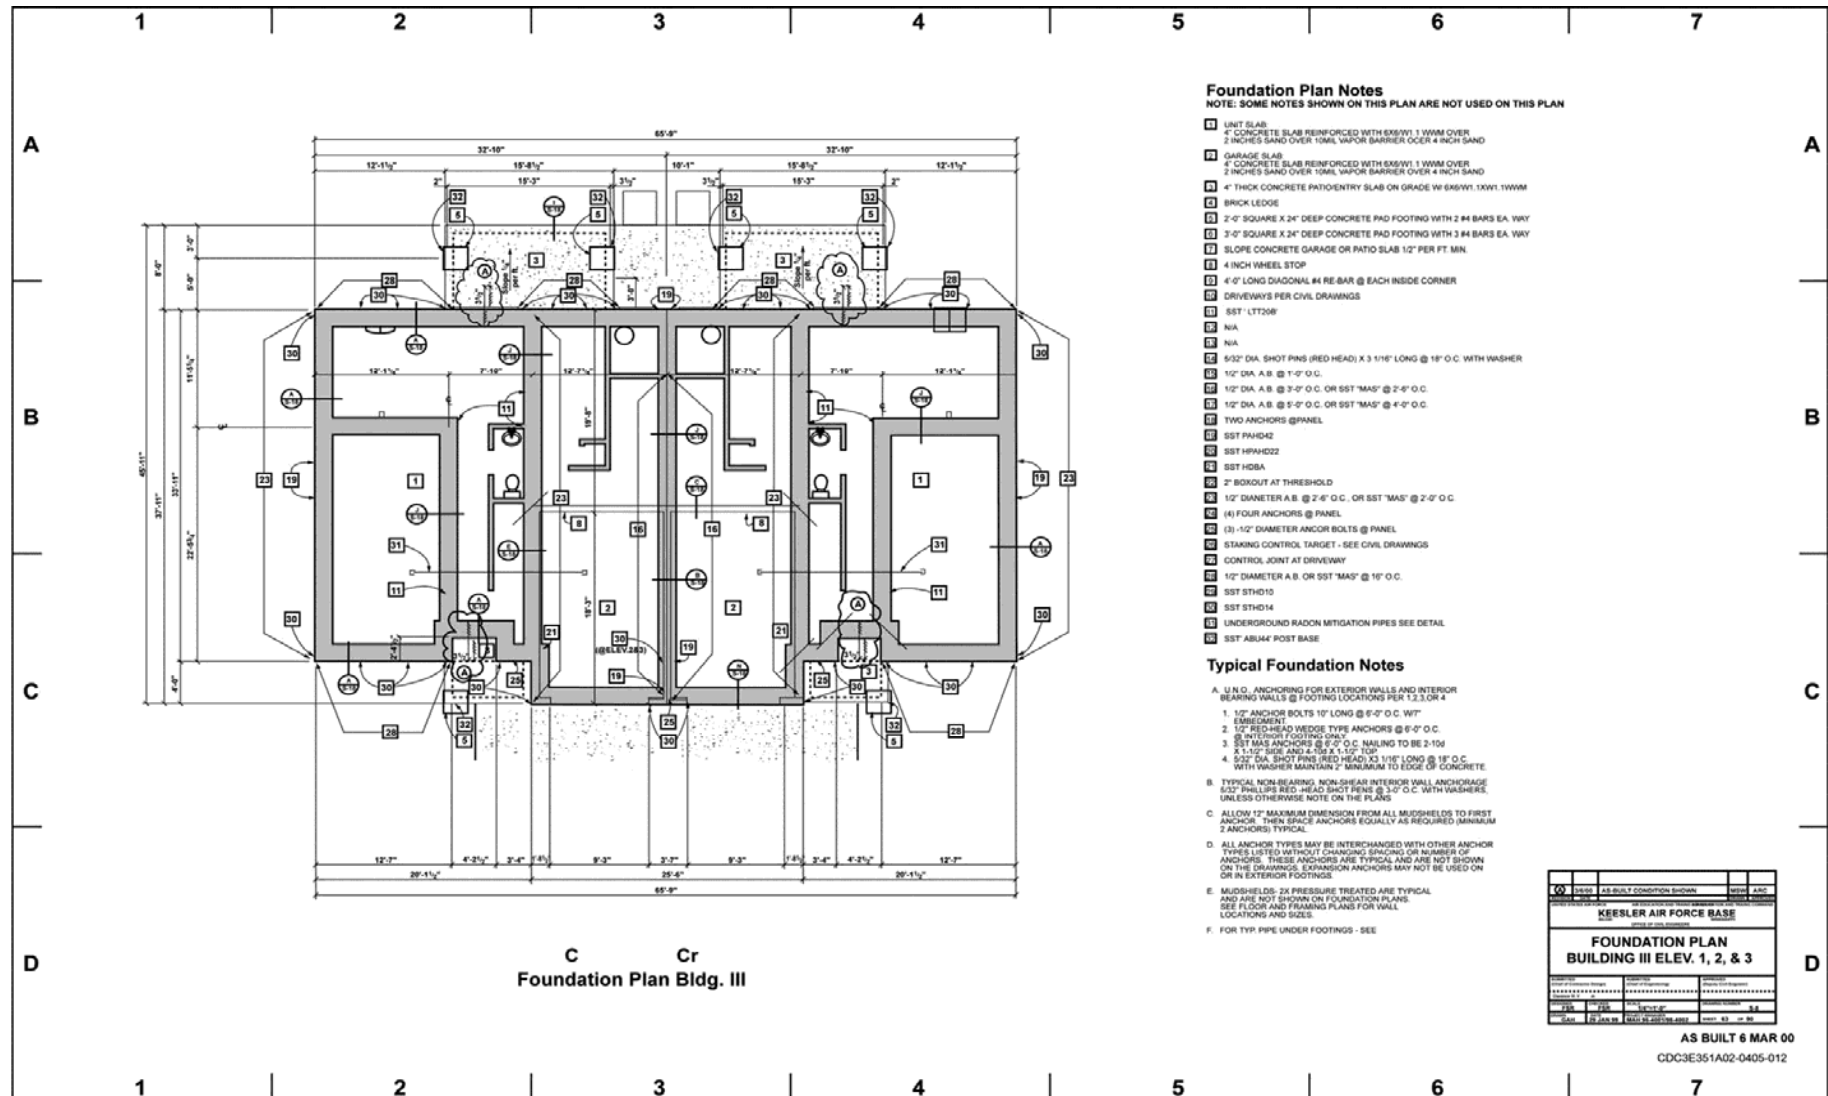

Foldout 5. Foundation plan.

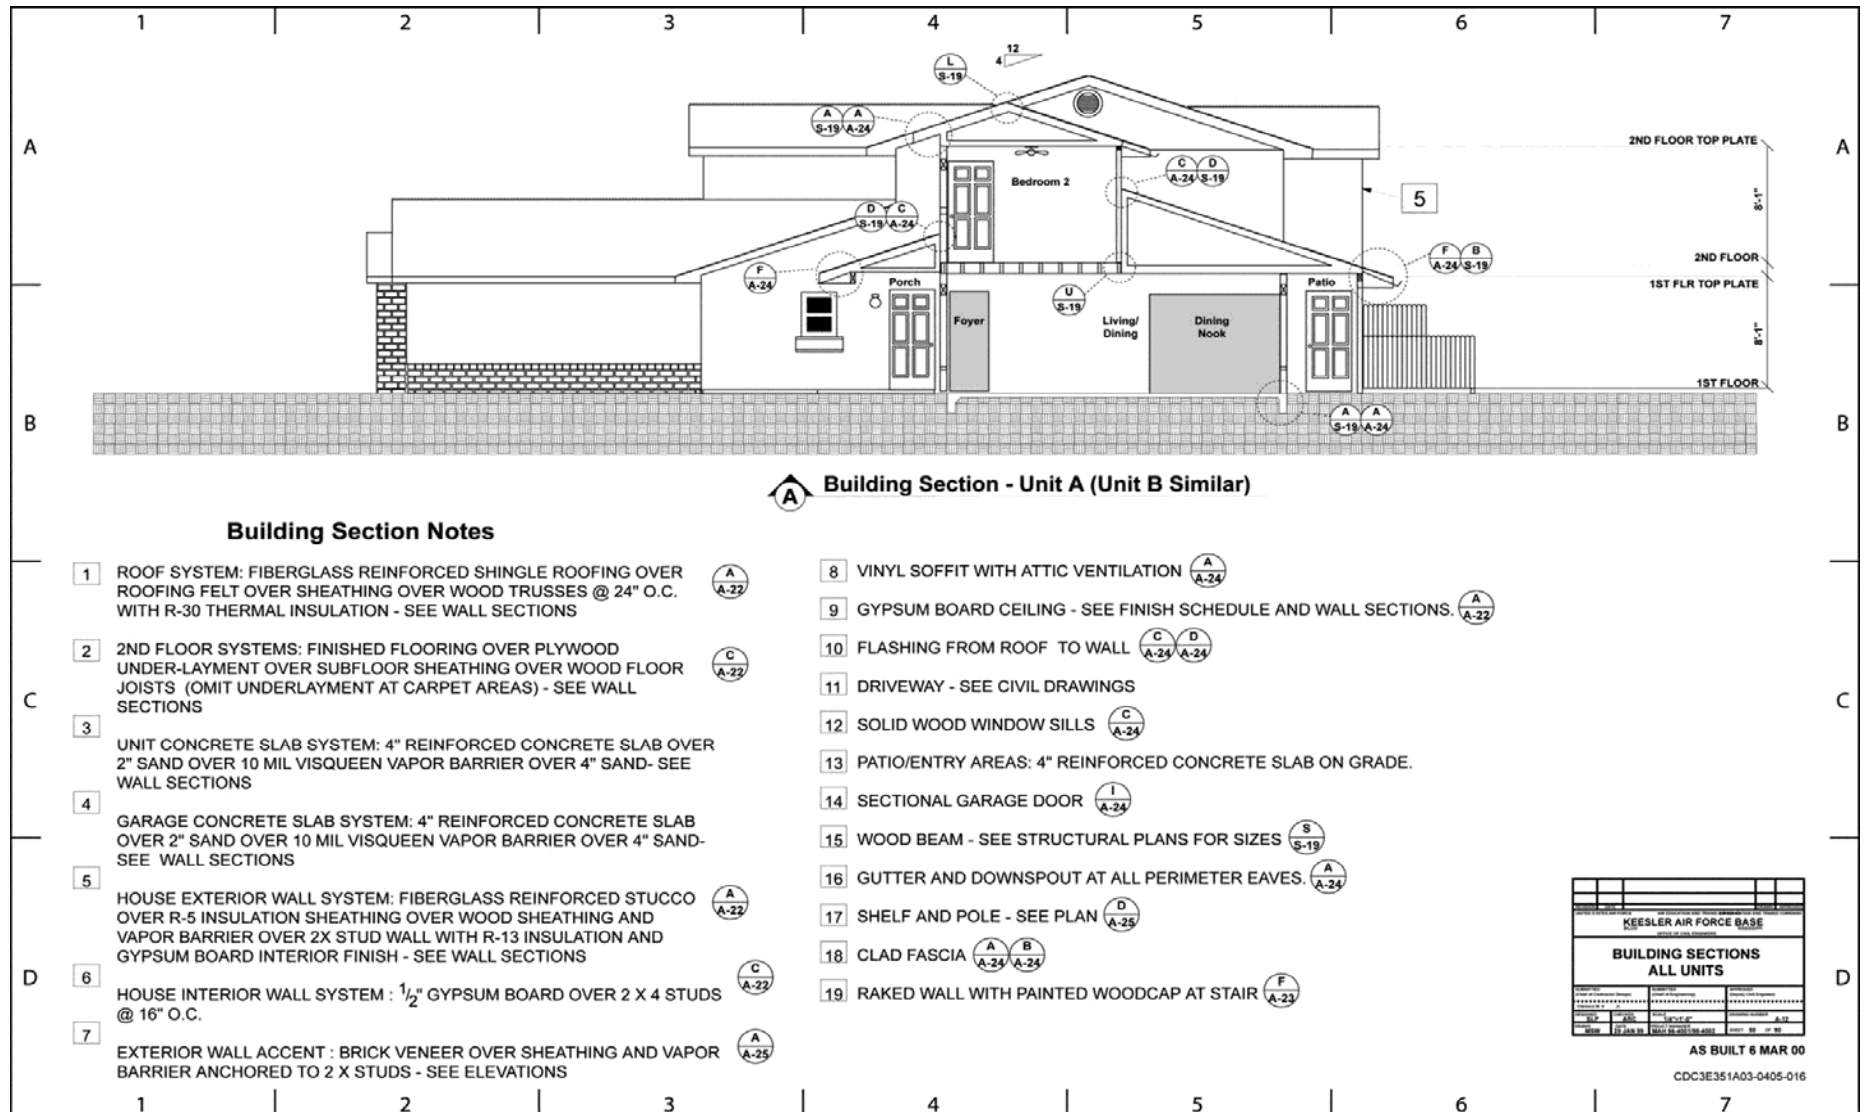

Foldout 6. Building section.

	1	2	3	4	5	6	7																																																																																																																																																																																																																																																																																																																																						
A	<b>EXTERIOR COLOR SCHEMES</b> (A)		<b>DOOR SCHEDULE</b> (A)		<b>FINISH SCHEDULE</b>																																																																																																																																																																																																																																																																																																																																								
A	ROOF SHINGLE : CERTAINTED - HATTERAS STORMY NIGHT STUCCO : OMEGA - SEA SHELL BRICK : ACME BRICK - KINGSIZE SMOKEY MOUNTAIN SHUTTERS : ALSIDE - BROWN SOLID STYLE CLADDING & SOFFIT : ALSIDE VINYL - WHITE GUTTER & DOWNSPOUT : ALSIDE ALUMINUM - WHITE		<table border="1" style="width: 100%; border-collapse: collapse;"> <thead> <tr> <th>SIZE</th> <th>TYPE</th> <th>FACE</th> <th>FINISH</th> <th>FRAME</th> <th>REMARKS</th> </tr> </thead> <tbody> <tr><td>1</td><td>3'-0" x 6'-8" x 1 3/4"</td><td>INSULATED</td><td>METAL</td><td>PAINTED</td><td>WOOD - EMBOSSED &amp; PANEL DESIGN</td></tr> <tr><td>2</td><td>3'-0" x 6'-8" x 1 3/4"</td><td>INSULATED</td><td>METAL</td><td>PAINTED</td><td>WOOD - 6 PANEL DESIGN W/SELF CLOSING(2)</td></tr> <tr><td>3</td><td>3'-0" x 6'-8" x 1 3/4"</td><td>INSULATED</td><td>METAL</td><td>PAINTED</td><td>WOOD - 6 PANEL DESIGN</td></tr> <tr><td>4</td><td>4'-0" x 6'-8" x 1 3/4"</td><td>PATIO DOOR</td><td>METAL GLASS</td><td>PAINTED</td><td>WOOD - 6 PANEL DESIGN</td></tr> <tr><td>5</td><td>2'-0" x 6'-8" x 1 3/4"</td><td>HOLLOW CORE</td><td>HARDBOARD</td><td>PAINTED</td><td>WOOD - DOUBLE GLAZED WITH INTERNAL GRID(1)</td></tr> <tr><td>6</td><td>2'-0" x 6'-8" x 1 3/4"</td><td>HOLLOW CORE</td><td>HARDBOARD</td><td>PAINTED</td><td>WOOD - 6 PANEL DESIGN</td></tr> <tr><td>7</td><td>1'-0" x 6'-8" x 1 3/4"</td><td>HOLLOW CORE</td><td>HARDBOARD</td><td>PAINTED</td><td>WOOD - 6 PANEL DESIGN</td></tr> <tr><td>8</td><td>3'-0" x 6'-8" x 1 3/4"</td><td>WARDROBE BLINDS</td><td>HARDBOARD</td><td>PAINTED</td><td>GYP BD - 6 PANEL DESIGN</td></tr> <tr><td>9</td><td>4'-0" x 6'-8" x 1 3/4"</td><td>WARDROBE BLINDS</td><td>HARDBOARD</td><td>PAINTED</td><td>GYP BD - 6 PANEL DESIGN</td></tr> <tr><td>10</td><td>6'-0" x 7'-0"</td><td>SECTIONAL GARAGE</td><td>METAL</td><td>PAINTED</td><td>WOOD - 6 PANEL DESIGN</td></tr> <tr><td>11</td><td>6'-0" x 6'-8" x 1 3/4"</td><td>WARDROBE BLINDS</td><td>HARDBOARD</td><td>PAINTED</td><td>GYP BD - 6 PANEL DESIGN</td></tr> </tbody> </table> GENERAL NOTE: 1. ONE FIXED PANEL, ONE ACTIVE PANEL 2. MINIMUM 20 MINUTE FIRE RATING		SIZE	TYPE	FACE	FINISH	FRAME	REMARKS	1	3'-0" x 6'-8" x 1 3/4"	INSULATED	METAL	PAINTED	WOOD - EMBOSSED & PANEL DESIGN	2	3'-0" x 6'-8" x 1 3/4"	INSULATED	METAL	PAINTED	WOOD - 6 PANEL DESIGN W/SELF CLOSING(2)	3	3'-0" x 6'-8" x 1 3/4"	INSULATED	METAL	PAINTED	WOOD - 6 PANEL DESIGN	4	4'-0" x 6'-8" x 1 3/4"	PATIO DOOR	METAL GLASS	PAINTED	WOOD - 6 PANEL DESIGN	5	2'-0" x 6'-8" x 1 3/4"	HOLLOW CORE	HARDBOARD	PAINTED	WOOD - DOUBLE GLAZED WITH INTERNAL GRID(1)	6	2'-0" x 6'-8" x 1 3/4"	HOLLOW CORE	HARDBOARD	PAINTED	WOOD - 6 PANEL DESIGN	7	1'-0" x 6'-8" x 1 3/4"	HOLLOW CORE	HARDBOARD	PAINTED	WOOD - 6 PANEL DESIGN	8	3'-0" x 6'-8" x 1 3/4"	WARDROBE BLINDS	HARDBOARD	PAINTED	GYP BD - 6 PANEL DESIGN	9	4'-0" x 6'-8" x 1 3/4"	WARDROBE BLINDS	HARDBOARD	PAINTED	GYP BD - 6 PANEL DESIGN	10	6'-0" x 7'-0"	SECTIONAL GARAGE	METAL	PAINTED	WOOD - 6 PANEL DESIGN	11	6'-0" x 6'-8" x 1 3/4"	WARDROBE BLINDS	HARDBOARD	PAINTED	GYP BD - 6 PANEL DESIGN	<table border="1" style="width: 100%; border-collapse: collapse;"> <thead> <tr> <th>SYMBOLS</th> <th>FLOOR</th> <th>BASE</th> <th>WALLS</th> <th>CEILING</th> <th>H</th> </tr> </thead> <tbody> <tr> <td>● SEMI-GLOSS PAINT</td> <td></td> <td></td> <td></td> <td></td> <td></td> </tr> <tr> <td>● SATIN FINISH PAINT</td> <td></td> <td></td> <td></td> <td></td> <td></td> </tr> <tr> <td>● FACTORY FINISHED OR PRE-FINISHED SEE SPECIFICATIONS</td> <td></td> <td></td> <td></td> <td></td> <td></td> </tr> <tr> <td>● NATURAL/UNFINISHED</td> <td></td> <td></td> <td></td> <td></td> <td></td> </tr> </tbody> </table> <table border="1" style="width: 100%; border-collapse: collapse;"> <thead> <tr> <th>ROOM NAMES</th> <th>CARPET</th> <th>SHEET VINYL</th> <th>VINYL COMPOSITION TILE</th> <th>CONCRETE</th> <th>WOOD BASE</th> <th>PAINT</th> <th>1/2" GYPSUM BOARD EXCEPT (5)</th> <th>1/2" WATER RESISTANT GYP BD EXCEPT (5,10)</th> <th>5/8" TYPE "X" GYP BD (PAINT ONLY)</th> <th>1/2" GYPSUM BOARD EXCEPT (4)</th> <th>1/2" GYP BD LOM ACUSTIC PANEL EXCEPT (4)</th> <th>5/8" TYPE "X" GYP BD (PAINT ONLY)</th> <th>CEILING</th> </tr> </thead> <tbody> <tr><td>TOILET</td><td></td><td></td><td></td><td></td><td></td><td></td><td></td><td></td><td></td><td></td><td></td><td></td><td></td></tr> <tr><td>FAMILY</td><td></td><td></td><td></td><td></td><td></td><td></td><td></td><td></td><td></td><td></td><td></td><td></td><td></td></tr> <tr><td>LIVING / DINING</td><td></td><td></td><td></td><td></td><td></td><td></td><td></td><td></td><td></td><td></td><td></td><td></td><td></td></tr> <tr><td>KITCHEN (1)</td><td></td><td></td><td></td><td></td><td></td><td></td><td></td><td></td><td></td><td></td><td></td><td></td><td></td></tr> <tr><td>BATH</td><td></td><td></td><td></td><td></td><td></td><td></td><td></td><td></td><td></td><td></td><td></td><td></td><td></td></tr> <tr><td>POWDER</td><td></td><td></td><td></td><td></td><td></td><td></td><td><STORAGE (3)</td><td></td><td></td><td></td><td></td><td></td><td></td><td></td><td></td><td></td><td></td><td></td><td></td><td></td></tr> <tr><td>EXTERIOR BULK STORAGE(2)</td><td></td><td></td><td></td><td></td><td></td><td></td><td></td><td></td><td></td><td></td><td></td><td></td><td></td></tr> <tr><td>GARAGE</td><td></td><td></td><td></td><td></td><td></td><td></td><td></td><td></td><td></td><td></td><td></td><td></td><td></td></tr> <tr><td>MECHANICAL ROOM</td><td></td><td></td><td></td><td></td><td></td><td></td><td></td><td></td><td></td><td></td><td></td><td></td><td></td></tr> </tbody> </table> (1) SEE FLOOR PLAN FOR LIMITS OF FURRED 7'-0" CEILING (2) SEE FLOOR PLAN FOR LIMITS OF FURRED 7'-0" CEILING (3) CARPET INTERIOR BULK STORAGE UNIT C ONLY (4) 5/8" GYPSUM BOARD AT FIRST FLOOR CEILING (5) 5/8" TYPE "X" GYPSUM BOARD AT PARTY WALLS ONLY (6) 5/8" TYPE "X" WATER RESISTANT GYPSUM BOARD AT PARTY WALL LOCATIONS AT TUBS OF UNIT C			SYMBOLS	FLOOR	BASE	WALLS	CEILING	H	● SEMI-GLOSS PAINT						● SATIN FINISH PAINT						● FACTORY FINISHED OR PRE-FINISHED SEE SPECIFICATIONS						● NATURAL/UNFINISHED						ROOM NAMES	CARPET	SHEET VINYL	VINYL COMPOSITION TILE	CONCRETE	WOOD BASE	PAINT	1/2" GYPSUM BOARD EXCEPT (5)	1/2" WATER RESISTANT GYP BD EXCEPT (5,10)	5/8" TYPE "X" GYP BD (PAINT ONLY)	1/2" GYPSUM BOARD EXCEPT (4)	1/2" GYP BD LOM ACUSTIC PANEL EXCEPT (4)	5/8" TYPE "X" GYP BD (PAINT ONLY)	CEILING	TOILET														FAMILY														LIVING / DINING														KITCHEN (1)														BATH														POWDER														STAIRS														HALL														BELOCK/CLAMS														CLOSETS														UTILITY														INTERIOR BULK STORAGE (3)														EXTERIOR BULK STORAGE(2)														GARAGE														MECHANICAL ROOM													
SIZE	TYPE	FACE	FINISH	FRAME	REMARKS																																																																																																																																																																																																																																																																																																																																								
1	3'-0" x 6'-8" x 1 3/4"	INSULATED	METAL	PAINTED	WOOD - EMBOSSED & PANEL DESIGN																																																																																																																																																																																																																																																																																																																																								
2	3'-0" x 6'-8" x 1 3/4"	INSULATED	METAL	PAINTED	WOOD - 6 PANEL DESIGN W/SELF CLOSING(2)																																																																																																																																																																																																																																																																																																																																								
3	3'-0" x 6'-8" x 1 3/4"	INSULATED	METAL	PAINTED	WOOD - 6 PANEL DESIGN																																																																																																																																																																																																																																																																																																																																								
4	4'-0" x 6'-8" x 1 3/4"	PATIO DOOR	METAL GLASS	PAINTED	WOOD - 6 PANEL DESIGN																																																																																																																																																																																																																																																																																																																																								
5	2'-0" x 6'-8" x 1 3/4"	HOLLOW CORE	HARDBOARD	PAINTED	WOOD - DOUBLE GLAZED WITH INTERNAL GRID(1)																																																																																																																																																																																																																																																																																																																																								
6	2'-0" x 6'-8" x 1 3/4"	HOLLOW CORE	HARDBOARD	PAINTED	WOOD - 6 PANEL DESIGN																																																																																																																																																																																																																																																																																																																																								
7	1'-0" x 6'-8" x 1 3/4"	HOLLOW CORE	HARDBOARD	PAINTED	WOOD - 6 PANEL DESIGN																																																																																																																																																																																																																																																																																																																																								
8	3'-0" x 6'-8" x 1 3/4"	WARDROBE BLINDS	HARDBOARD	PAINTED	GYP BD - 6 PANEL DESIGN																																																																																																																																																																																																																																																																																																																																								
9	4'-0" x 6'-8" x 1 3/4"	WARDROBE BLINDS	HARDBOARD	PAINTED	GYP BD - 6 PANEL DESIGN																																																																																																																																																																																																																																																																																																																																								
10	6'-0" x 7'-0"	SECTIONAL GARAGE	METAL	PAINTED	WOOD - 6 PANEL DESIGN																																																																																																																																																																																																																																																																																																																																								
11	6'-0" x 6'-8" x 1 3/4"	WARDROBE BLINDS	HARDBOARD	PAINTED	GYP BD - 6 PANEL DESIGN																																																																																																																																																																																																																																																																																																																																								
SYMBOLS	FLOOR	BASE	WALLS	CEILING	H																																																																																																																																																																																																																																																																																																																																								
● SEMI-GLOSS PAINT																																																																																																																																																																																																																																																																																																																																													
● SATIN FINISH PAINT																																																																																																																																																																																																																																																																																																																																													
● FACTORY FINISHED OR PRE-FINISHED SEE SPECIFICATIONS																																																																																																																																																																																																																																																																																																																																													
● NATURAL/UNFINISHED																																																																																																																																																																																																																																																																																																																																													
ROOM NAMES	CARPET	SHEET VINYL	VINYL COMPOSITION TILE	CONCRETE	WOOD BASE	PAINT	1/2" GYPSUM BOARD EXCEPT (5)	1/2" WATER RESISTANT GYP BD EXCEPT (5,10)	5/8" TYPE "X" GYP BD (PAINT ONLY)	1/2" GYPSUM BOARD EXCEPT (4)	1/2" GYP BD LOM ACUSTIC PANEL EXCEPT (4)	5/8" TYPE "X" GYP BD (PAINT ONLY)	CEILING																																																																																																																																																																																																																																																																																																																																
TOILET																																																																																																																																																																																																																																																																																																																																													
FAMILY																																																																																																																																																																																																																																																																																																																																													
LIVING / DINING																																																																																																																																																																																																																																																																																																																																													
KITCHEN (1)																																																																																																																																																																																																																																																																																																																																													
BATH																																																																																																																																																																																																																																																																																																																																													
POWDER																																																																																																																																																																																																																																																																																																																																													
STAIRS																																																																																																																																																																																																																																																																																																																																													
HALL																																																																																																																																																																																																																																																																																																																																													
BELOCK/CLAMS																																																																																																																																																																																																																																																																																																																																													
CLOSETS																																																																																																																																																																																																																																																																																																																																													
UTILITY																																																																																																																																																																																																																																																																																																																																													
INTERIOR BULK STORAGE (3)																																																																																																																																																																																																																																																																																																																																													
EXTERIOR BULK STORAGE(2)																																																																																																																																																																																																																																																																																																																																													
GARAGE																																																																																																																																																																																																																																																																																																																																													
MECHANICAL ROOM																																																																																																																																																																																																																																																																																																																																													
B	ROOF SHINGLE : CERTAINTED - HATTERAS STORMY NIGHT STUCCO : OMEGA - BUCK SKIN BRICK : ACME BRICK - KINGSIZE SANTA ROSA SHUTTERS : ALSIDE - GREEN SOLID STYLE CLADDING & SOFFIT : ALSIDE VINYL - WHITE GUTTER & DOWNSPOUT : ALSIDE ALUMINUM - WHITE																																																																																																																																																																																																																																																																																																																																												
B	ROOF SHINGLE : CERTAINTED - HATTERAS STORMY NIGHT STUCCO : OMEGA - ARMADILLO SHELL BRICK : ACME BRICK - KINGSIZE MISSION ROUGE SHUTTERS : ALSIDE - GRAY SOLID STYLE CLADDING & SOFFIT : ALSIDE VINYL - WHITE GUTTER & DOWNSPOUT : ALSIDE ALUMINUM - WHITE																																																																																																																																																																																																																																																																																																																																												
C	<b>INTERIOR COLOR SCHEMES</b> (A)																																																																																																																																																																																																																																																																																																																																												
C	WALL PAINT: SHERWIN WILLIAMS - SW 1039 ZUICH CARPET : PATCRAFT COMMERCIAL 734-105 SERVICES SHEET VINYL : MANNINGTON CUSTOM SPEC II BOLERO 6409 VINYL COMPOSITION TILE : 137 KENTILE PEBBLE BEIGE CABINET : ZEE - OAK ALPINE STAIN KITCHEN COUNTER : WILSONART - 4143-60 NEUTRAL GLACE BATH COUNTER : DOMESTIC - CULTURED MARBLE WHITE ON WHITE HORIZONTAL BLIND : BALI GRABER - 544 TRUE WHITE VERTICAL BLIND : BALI GRABER - 3353 ALABASTER																																																																																																																																																																																																																																																																																																																																												
B	WALL PAINT: SHERWIN WILLIAMS - SW 1039 ZUICH CARPET : PATCRAFT COMMERCIAL 734-108 PROC. SHEET VINYL : MANNINGTON CUSTOM SPEC II BOLERO 6409 VINYL COMPOSITION TILE : 137 KENTILE OYSTER GREIGE CABINET : ZEE - OAK ALPINE STAIN KITCHEN COUNTER : WILSONART - 4628-60 SAND NEBULA BATH COUNTER : DOMESTIC - CULTURED MARBLE WHITE ON WHITE HORIZONTAL BLIND : BALI GRABER - 544 TRUE WHITE VERTICAL BLIND : BALI GRABER - 3353 ALABASTER																																																																																																																																																																																																																																																																																																																																												
D	WALL PAINT: SHERWIN WILLIAMS - SW 1039 ZUICH CARPET : PATCRAFT COMMERCIAL 734-126 CAPITOL SHEET VINYL : MANNINGTON CUSTOM SPEC II BOLERO 6402 VINYL COMPOSITION TILE : 111 KENTILE MINERAL WHITE CABINET : ZEE - OAK ALPINE STAIN KITCHEN COUNTER : WILSONART - 4142-60 GRAY GLACE BATH COUNTER : DOMESTIC - CULTURED MARBLE WHITE ON WHITE HORIZONTAL BLIND : BALI GRABER - 544 TRUE WHITE VERTICAL BLIND : BALI GRABER - 3353 ALABASTER																																																																																																																																																																																																																																																																																																																																												

KEESLER AIR FORCE BASE	
SCHEDULES	
ALL UNITS	
AS BUILT 6 MAR 00	CDC3E351A03-0405-009

Foldout 7. Schedules.

Foldout 8. General notes.

## **Student Notes**

**AFSC 3E351**  
**D3E351 02 S01 1509**  
**Edit Code 01**